



TYPICAL PARKING SPACES

"DO NOT ENTER" SIGNS

TRAFFIC ARROWS (TYPICAL)

"ONE WAY" ARROW SIGNS

EXTENDED STOP LINE ACROSS LANE

CHANGED ONE PARKING STALL TO VAN ACCESSIBLE HANDICAP PARKING
ADDED STRIPED AREA


REMOVED 18 PARKING SPACES
AND PAVEMENT MARKINGS,
KEPT 16 PARKING SPACES

REMOVED 20 TYPICAL PARKING SPACES
REPLACED WITH 17 SLANTED BUS PARKING SPACES

WETLANDS 100' BUFFER

General Notes

No.	Revision/Issue	Date

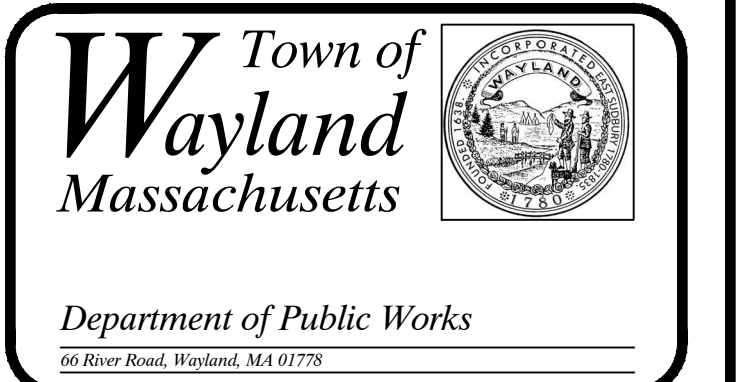

**TOWN HALL
AS-BUILT PARKING
LOT LAYOUT**
Wayland, Massachusetts

Project TOWN HALL PARKING LOT	Sheet 1
Date 11/23/2020	
Scale 1" = 50'	